

Job Number: 4606
 Projects Name: Wabowille HS
 Location: Wabowille OR
 Floor Level: FIRST FLOOR
 Drawing Type: LETTERS AND NUMBERS SCHEME
 Drawn By: mgonz
 SR: Tboyd
 Scale: 3/8"=1'
 Drawing Date: Apr 11, 2022



Balcony Level
 176 - Standard Seats
 5 - Wheel Chair Positions

Orchestra Level
 422 - Standard Seats
 5 - Wheel Chair Positions

Sub Totals
 598 - Standard Seats
 7 - Wheel Chair Positions

Total of 605 Seating Positions


Check current seat number matches request on lower level. Still need to see NDU Book 11/21/2022
 Change to verify seat numbering scheme

Options and accessories symbols
 No Letter

SUMMARY CHART

LETTERS	QUANTITY	LETTERS	QUANTITY
A	4	U	1
B	4	T	6
C	4	S	4
D	4	R	4
E	4	Q	4
F	4	P	4
G	4	N	4
H	4	M	4
J	4	LHL	2
K	6	LHR	2
L	12	K	6
M	15	J	4
N	15	H	4
O	17	G	4
P	15	F	4
Q	15	E	4
R	20	D	4
S	13	C	4
T	22	B	4
U	14	A	4
TOTAL	77	TOTAL	422

AT THE TIME OF SCAN THE FINISHES WERE NOT YET BUILT.

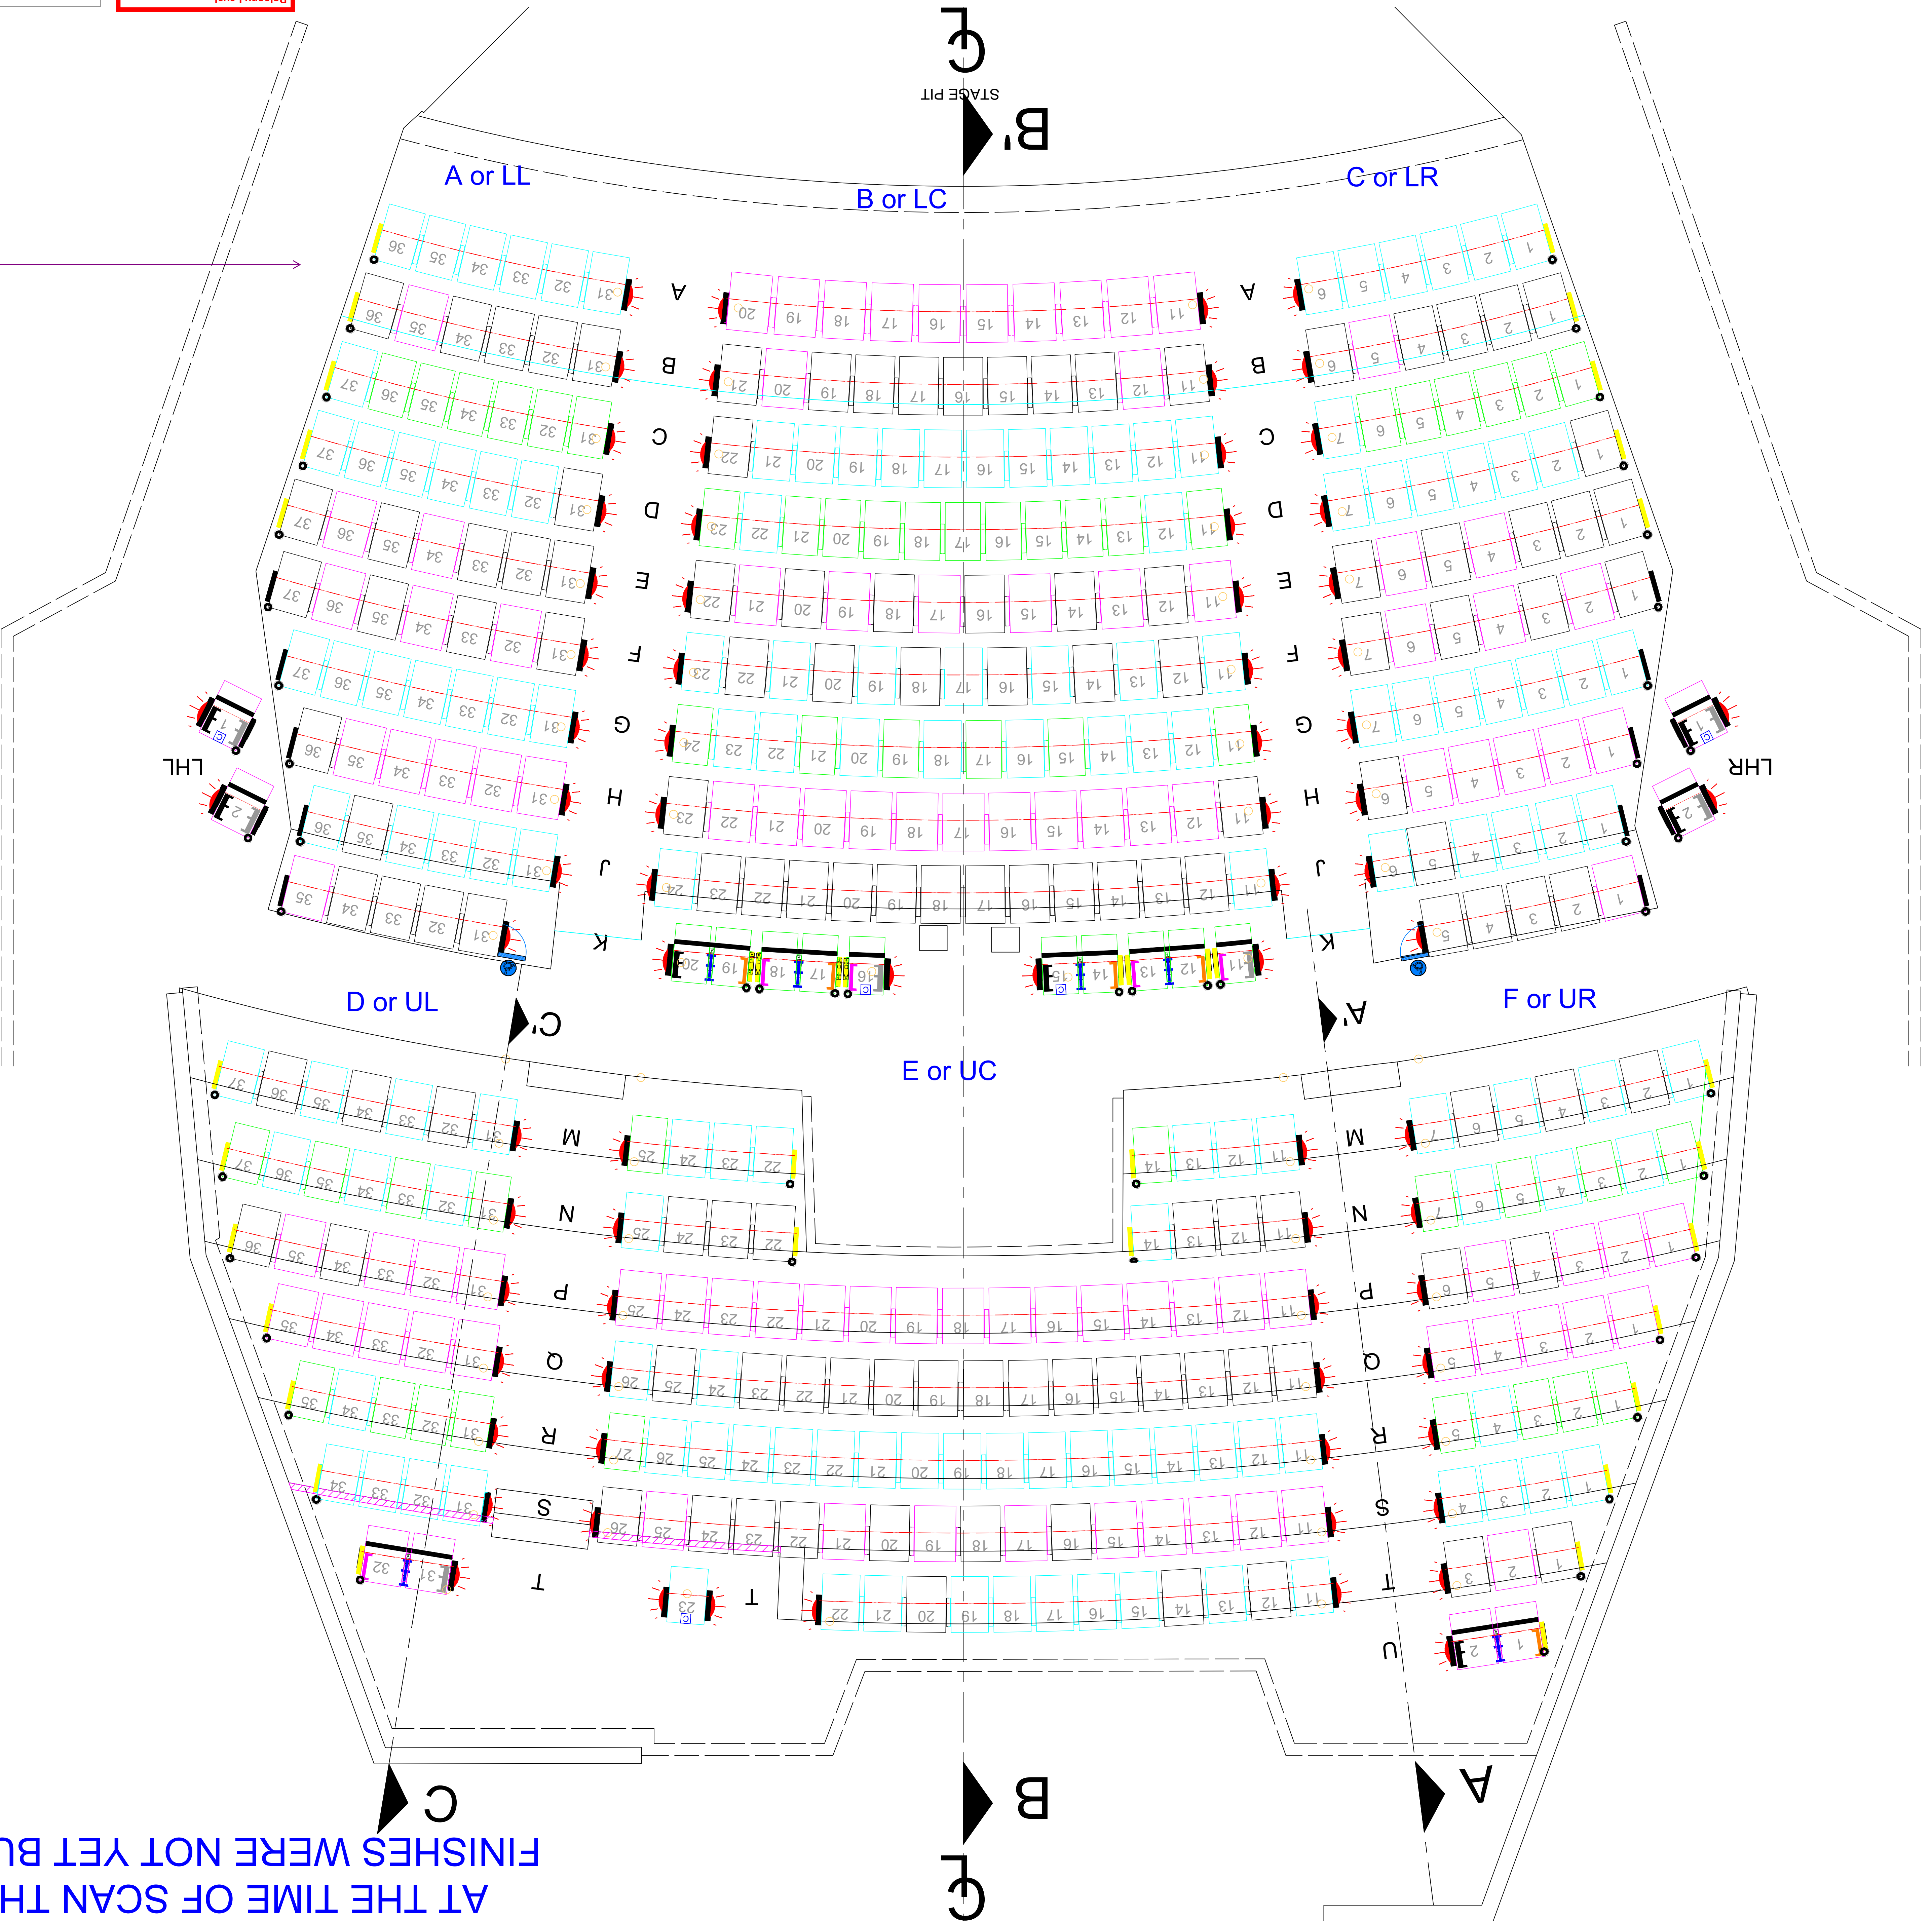

SUMMARY CHART

LETTERS	QUANTITY	LETTERS	QUANTITY
A	4	U	1
B	4	T	6
C	4	S	4
D	4	R	4
E	4	Q	4
F	4	P	4
G	4	N	4
H	4	M	4
J	4	LHL	2
K	6	LHR	2
L	12	K	6
M	15	J	4
N	15	H	4
O	17	G	4
P	15	F	4
Q	15	E	4
R	20	D	4
S	13	C	4
T	22	B	4
U	14	A	4
TOTAL	77	TOTAL	422

Balcony Level
 176 - Standard Seats
 5 - Wheel Chair Positions

Orchestra Level
 422 - Standard Seats
 5 - Wheel Chair Positions

Sub Totals
 598 - Standard Seats
 7 - Wheel Chair Positions

Total of 605 Seating Positions


SEIRIES
 SEATING
 www.seiriesseating.com

Job Number: 4606
 Projects Name: Wabonville HS
 Location: Wabonville OR
 Floor Level: BALCONY
 Drawing Type: LETTERS SCHEME
 Drawn By: mgonz
 SR: Tloyd
 Scale: 3/8"=1'
 Drawing Date: Apr 11, 2022

Drawing Number: TS-1.4/ 3.1

NOTICE TO ALL PERSONS RECEIVING THIS DRAWING
 This drawing contains confidential proprietary information and is issued in confidence on the condition that it is returned on demand and is not to be copied, reproduced, disclosed to others or used without the written consent of SEIRIES USA.

OPTIONS AND ACCESSORIES SYMBOLS

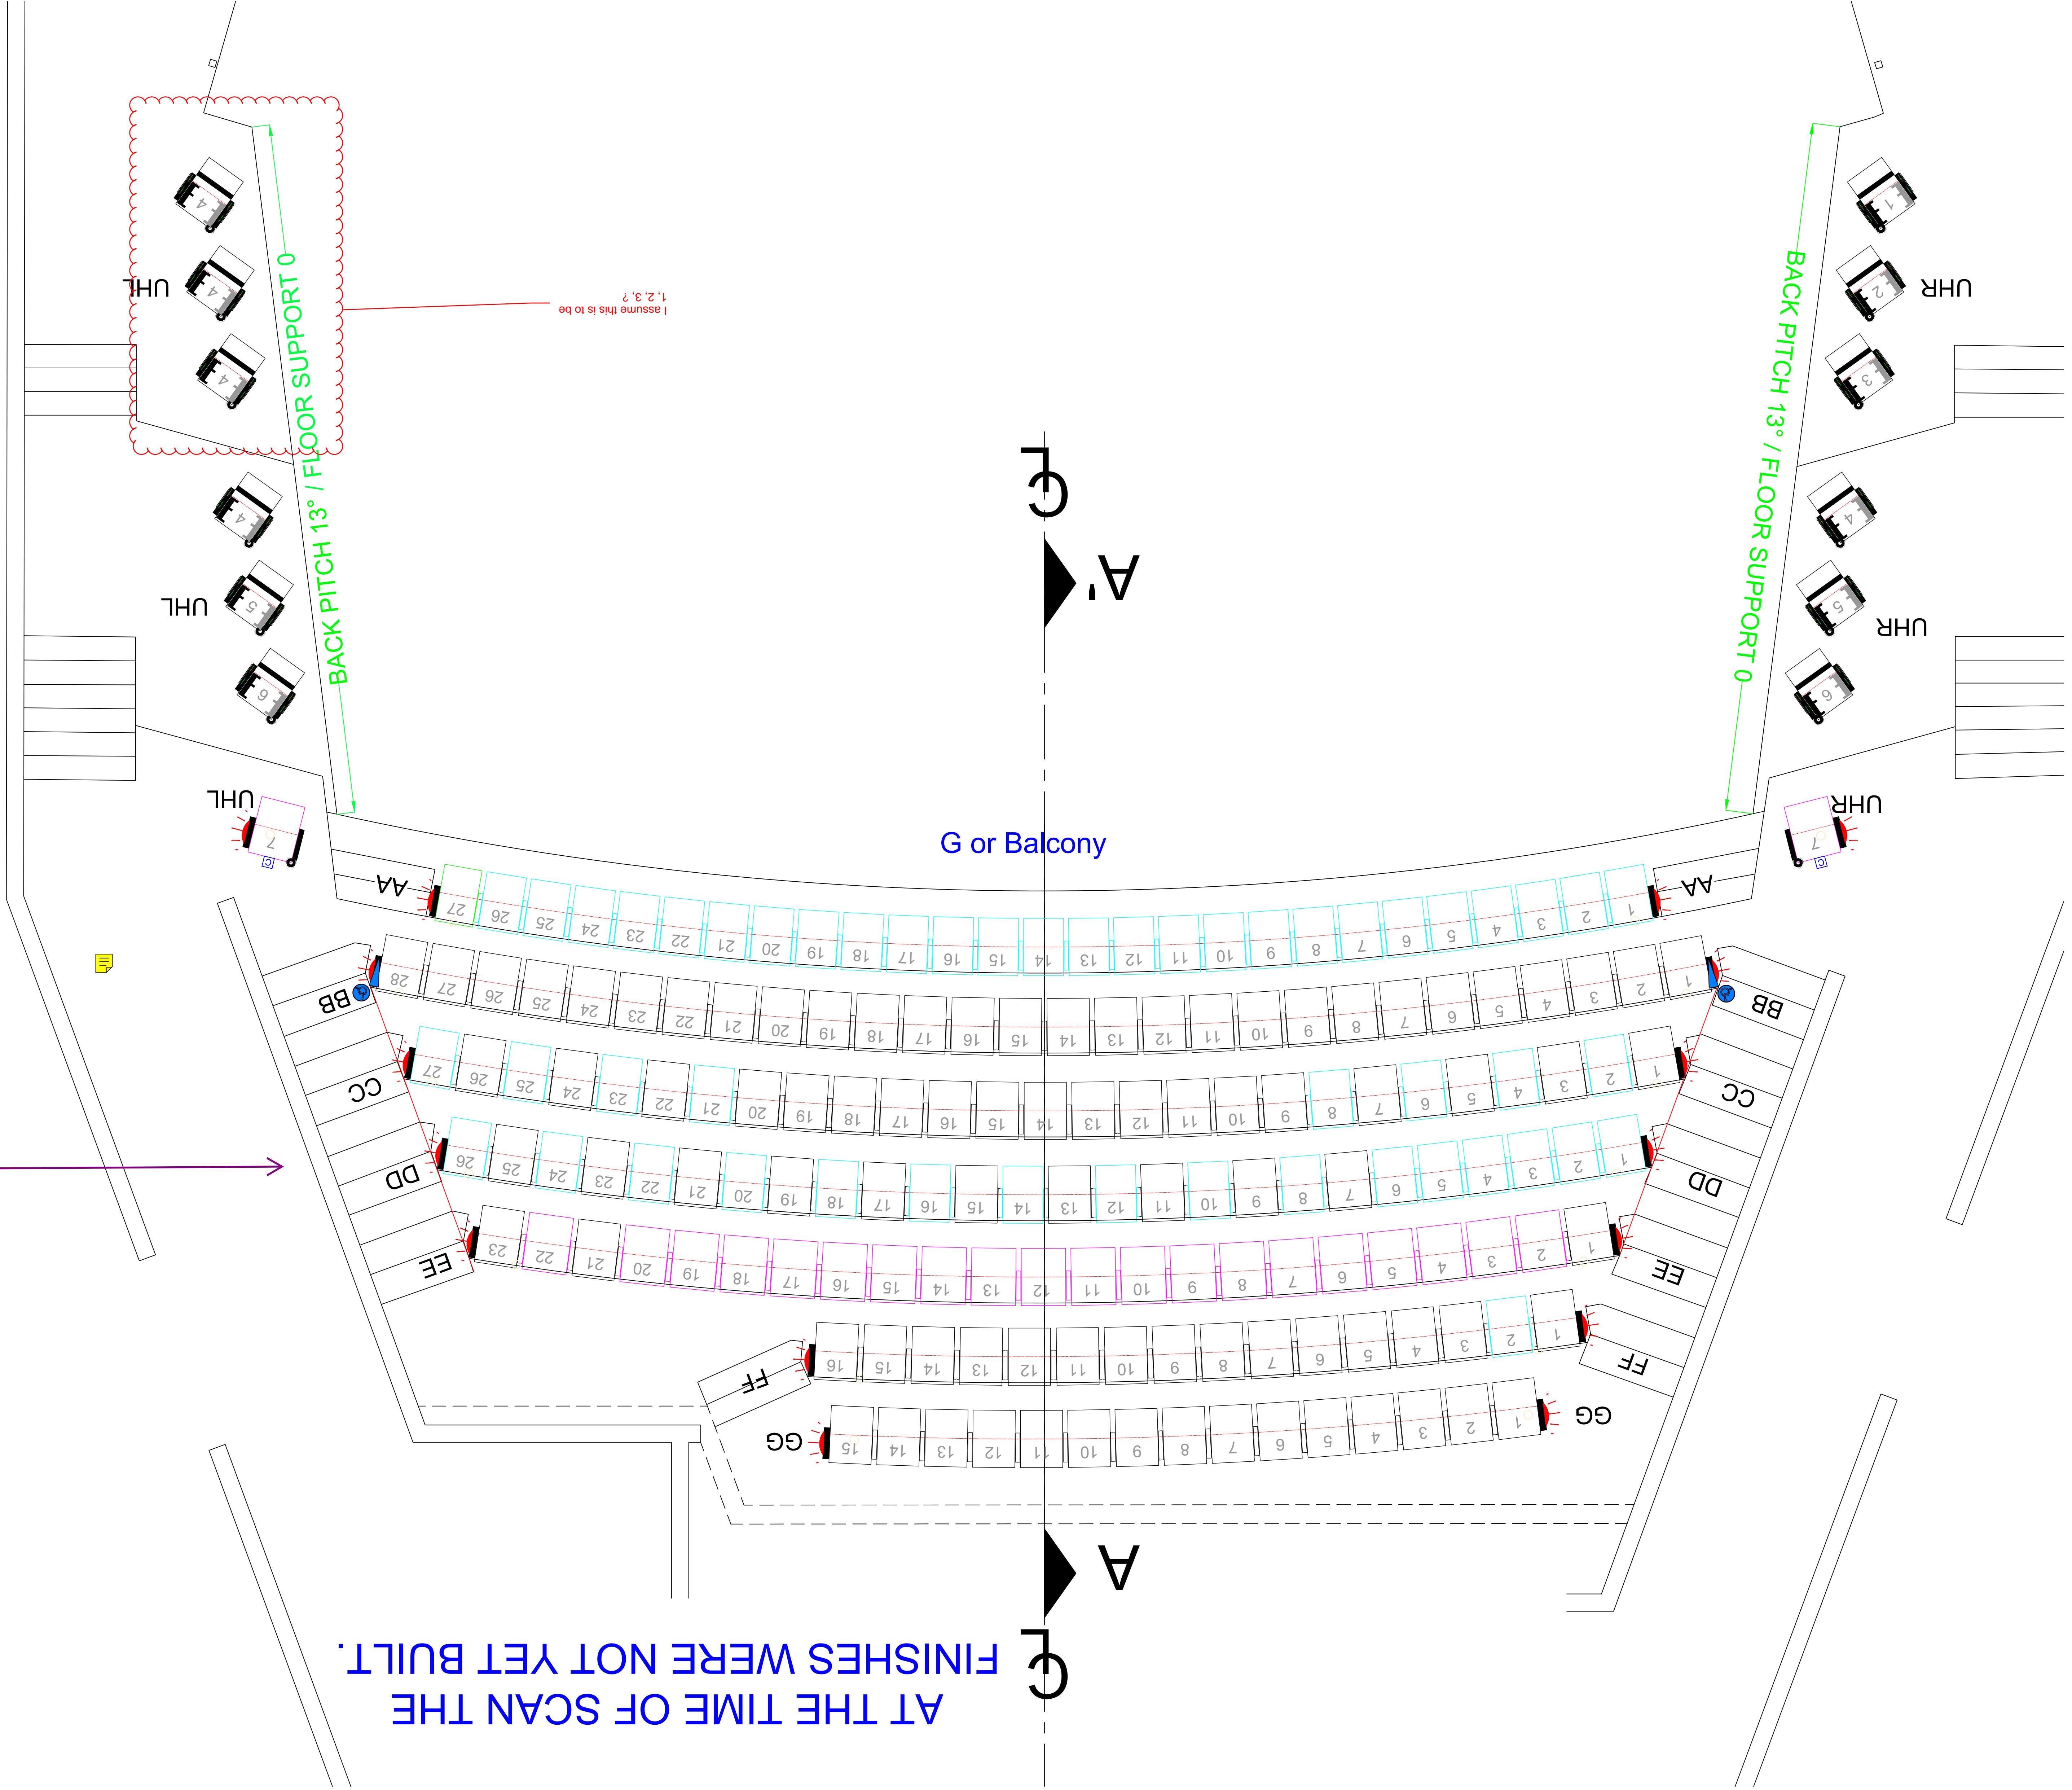

Owner to verify seat numbering scheme

WLWV District has confirmed seat numbering - Ryan Hendicks 12/15/22

SUMMARY CHART

LETTERS	QUANTITY	TOTAL
AA	2	2
BB	2	2
CC	2	2
DD	2	2
EE	2	2
FF	2	2
GG	2	2
UHL	7	7
UHR	7	7
TOTAL	28	28

SUMMARY CHART

NUMBERS	QUANTITY	TOTAL
1	9	9
2	9	9
3	9	9
4	9	9
5	9	9
6	9	9
7	9	9
8	9	9
9	7	7
10	7	7
11	7	7
12	7	7
13	7	7
14	7	7
15	7	7
16	6	6
17	5	5
18	5	5
19	5	5
20	5	5
21	5	5
22	5	5
23	5	5
24	4	4
25	4	4
26	4	4
27	3	3
28	1	1
TOTAL	176	176